



- BRANCH LINE

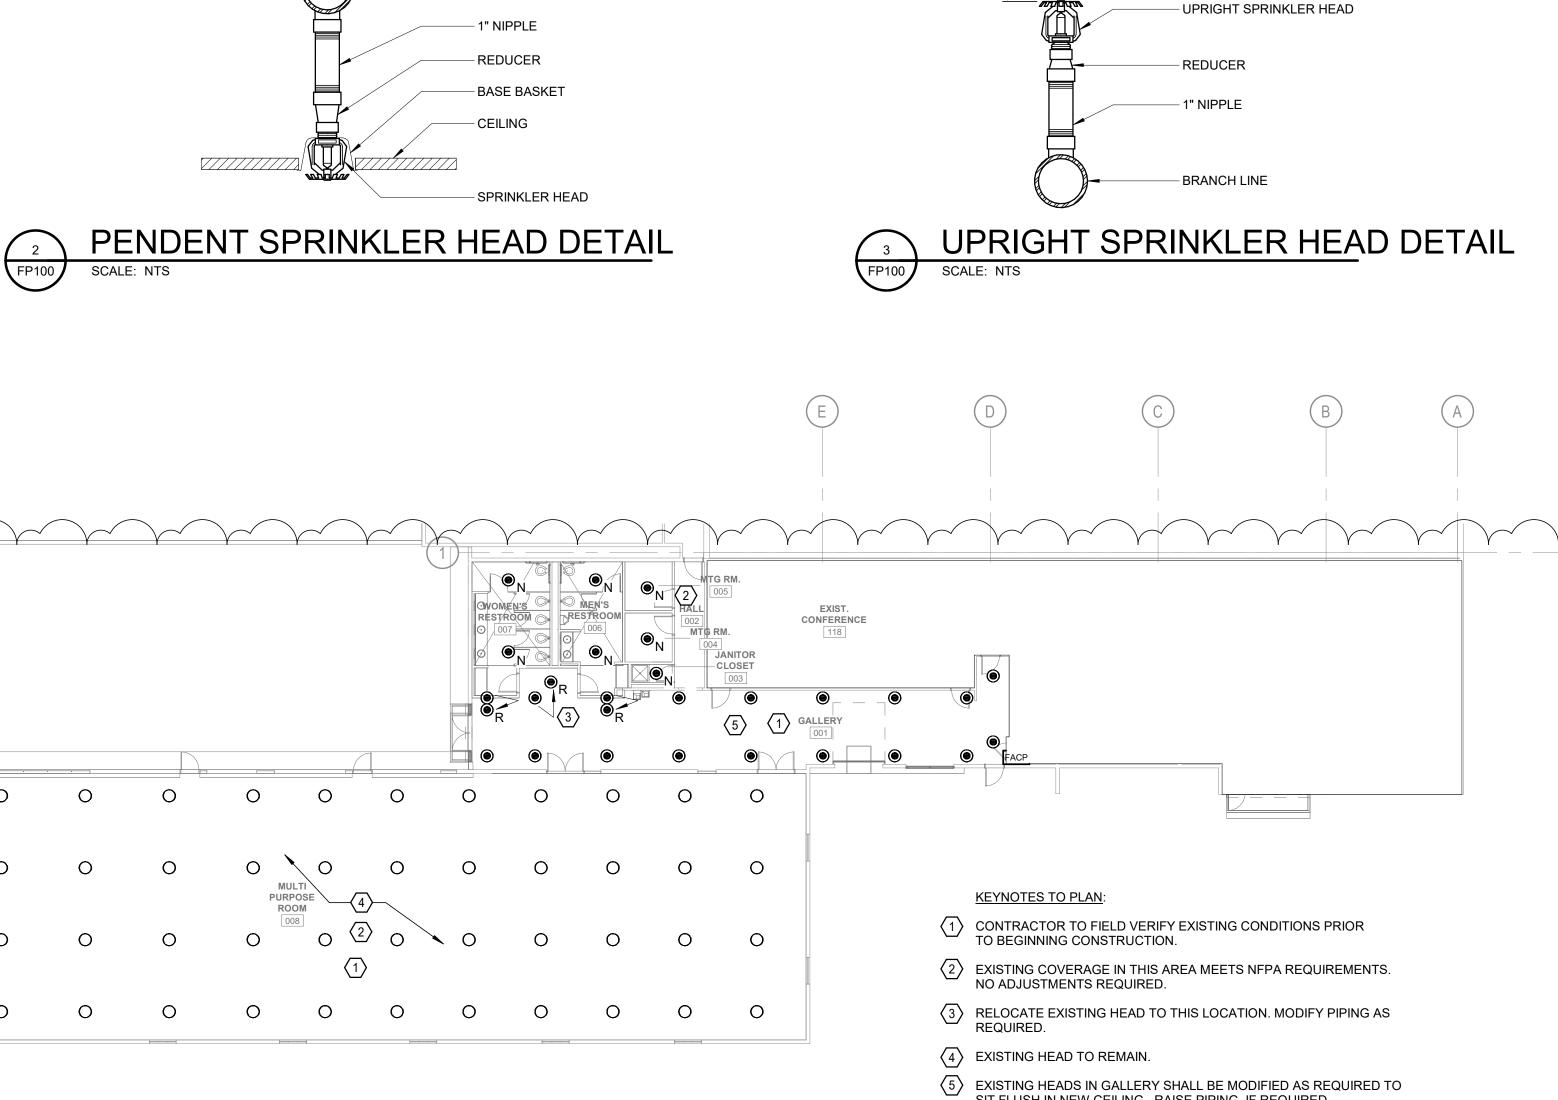

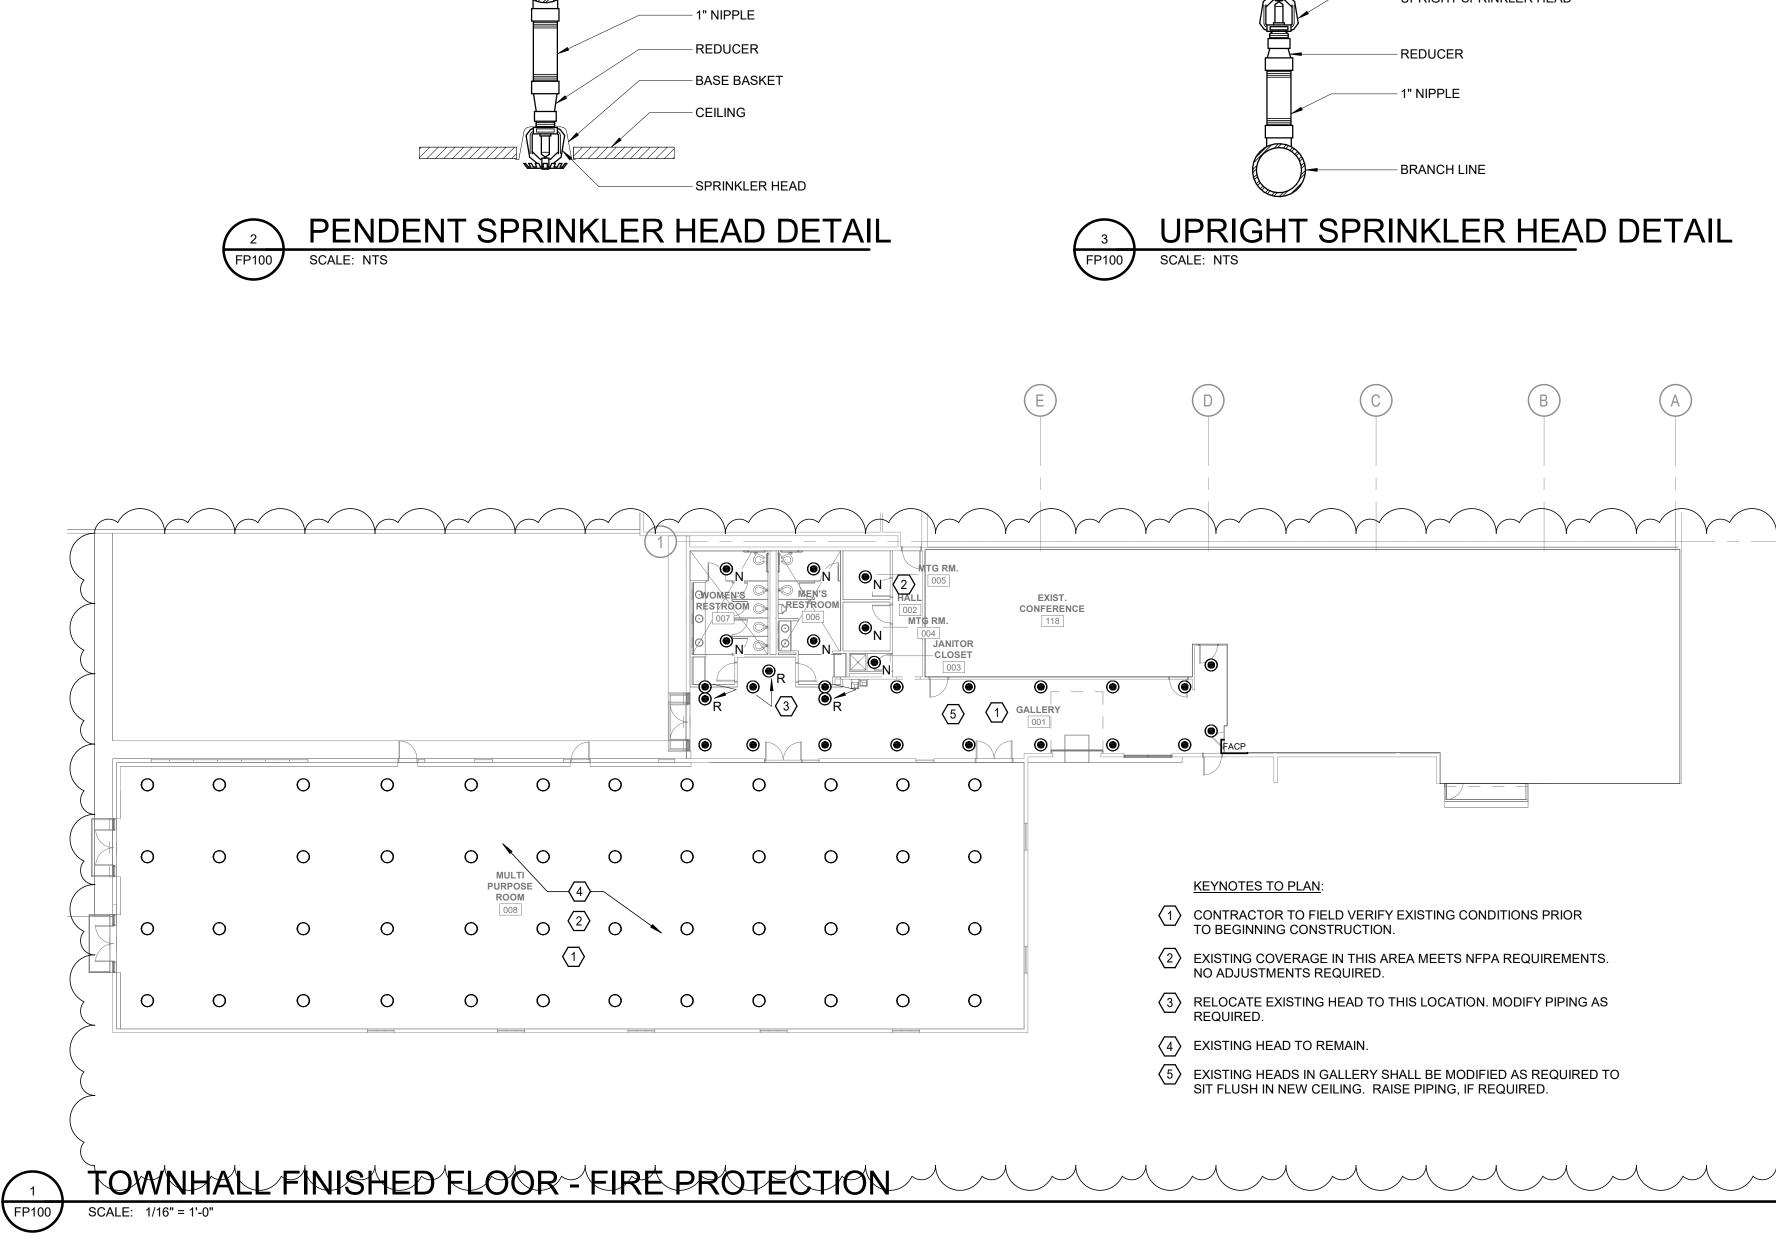

FIRE PROTECTION NOTES

- 1. FIELD VERIFY EXACT LOCATION OF EXISITING FIRE MAIN. 2. FIRE PROTECTION CONTRACTOR SHALL COORDINATE HIS WORK PRIOR TO INSTALLATION WITH MECHANICAL, ELECTRICAL, STRUCTURAL, & PLUMBING CONTRACTOR & ARCHITECTURAL PLANS TO AVOID CONFLICTS.
- 3. FIRE PROTECTION CONTRACTOR SHALL BE RESPONSIBLE FOR MAINTAINING ALL FIRE RATINGS WHERE PIPES PENETRATE FIRE RATED ASSEMBLIES, FIRE SAFING MATERIAL SHALL BE UL LISTED.
- 4. SUBMIT SHOP DRAWINGS TO LOCAL FIRE MARSHALL AND OWNER'S INSURANCE UNDERWRITER FOR APPROVAL.
- 5. ALL SPRINKLER PIPING INSTALLATION SHALL CONFORM TO NFPA 13, 2007 EDITION. NEW PIPE SHALL BE SCHEDULE 40 STEEL.
- 6. ALL SPRINKLER HEADS SHALL BE CENTERED IN CEILING TILE.
- 7. SPRINKLER CONTRACTOR SHALL PROVIDE HEAD LOCATIONS AND ELEVATIONS WITH ARCHITECTURAL REFLECTED CEILING PLAN.
- 8. ALL CHANGES OR ADDITIONS TO THE EXISTING SPRINKLER SYSTEM MUST COMPLY WITH CHAPTER 13 OF ASCE7-05. PROVIDE SEISMIC RESTRAINTS AS REQUIRED FOR BUILDING SEISMIC DESIGN CATEGORY "C". 9. TAP OFF FIRE SPRINKLER MAIN WITH 1" SCHEDULE 40 STEEL PIPE
- TO CONNECT NEW SPRINKLER HEADS TO SYSETM. 10. CONTRACTOR SHALL VERIFY EXISTING HEAD LOCATIONS BEFORE INSTALLATION AND PROVIDE ADDITIONAL SPRINKLER HEADS AS NEEDED TO ENSURE PROPER COVERAGE PER NFPA
- 13.

BOTTOM OF ROOF OR FLOOR DECK

DESIGN CRITERIA

UPFIT SPACE OCCUPANCY CLASSIFICATION - ORDINARY HAZARD, GROUP 1. DENSITY - .15 GPM/1500 SQ./FT. SYSTEM - WET MAXIMUM HEAD COVERAGE 130 SQ.FT. DESIGN SHALL BE PER NFPA 13. MATERIALS, VALVES, HANGERS SHALL BE PER NFPA 13.

SPRINKLER HEADS

SPRINKLER HEADS TO BE IN CENTER OF TILE. VERIFY EXISTING CONDITIONS BEFORE INSTALLATION.

◎ RELOCATED PENDENT SPRINKLER HEAD

- © EXISTING PENDENT SPRINKLER HEAD TO REMAIN
- O EXISTING UPRIGHT SPRINKLER HEAD TO REMAIN

O_N NEW SEMI-RECESSED, 5.6K, QUICK RESPONSE PENDENT SPRINKLER HEAD



	DESIGN	
	AND	
	LAND	
www.bodhilandanddesign.com BODHI Land and Design, PLLC. 918 Minerva Dale Drive Fuquay Varina, NC 27526 704.778.6608 Plans, maps, specifications, studies, and reports not containing a red ink seal imprint accompanied by an original signature by the licensed professional may have been fraudulently altered and shall not be considered an original copy. All information should be disregarded unless verified by the professional whose signature appears above. Copyright Protected 2018. Project Owner:		
LUCK'S CANNER REDEVELOPMEN -PHASE I- Seagrove, NC 2734	IT	
Stamp: CARO SEAL 040327 10/4/19 McNILL	Shin	
CONSTRUCTION Issue Date: 07.27.2019		
REVISIONS		
NO. REASON 1 Addendum #1	DATE 10.04.19	
PRINCIPAL IN CHARGE:		
D. WALKER Project Address:		
LUCK'S CANNERY - LO BLDG. RENNOVATION PHASE IA		
Project Number:		
201901.1 Sheet Title:		
TOWNHALL FLOOR PLAN FIRE PROTECT	1 -	
Sheet Number: FP100		

Architect: